



Box 129, Port Carling, ON, POB 1JO
Telephone (705) 765-3156
Fax (705) 765-6755

THE CORPORATION OF THE TOWNSHIP OF MUSKOKA LAKES
COMMITTEE OF ADJUSTMENT

NOTICE OF PUBLIC HEARING OF APPLICATION FOR MINOR VARIANCE

This notice has been sent to you for your information and does not require any response unless you wish to make one.

TAKE NOTICE THAT the Committee of Adjustment for The Corporation of the Township of Muskoka Lakes will be considering the following proposed minor variance to Zoning By-Law 2014-14 pursuant to Section 45 of the Planning Act, R.S.O. 1990, c. P.13.

Hearing Date: Monday, July 10th, 2023 at 9:00 a.m.

File #: A-22/23

Roll #: 9-8-052

Civic Address: 1191 Glen Gordon Road, Unit #11

Owners: Cynthia Chan, 267 Belize Avenue, Toronto, ON M4S 1M5

Legal Description: Plan 24, Lot 7 (Monck)

Lake/River: Leonard Lake (Category 4)

Zoning: Waterfront Residential (WR4)

Zoning Schedule: 38

EXPLANATION OF THE PURPOSE AND EFFECT: The applicant proposes to recognize an as-built dock addition.

Variance	ZBL 2014-14 Section(s)	Description	Required/Permitted	Proposed	Variance
A	4.1.7 and 4.1.7.11 b.	Minimum Side Yard Setback for a Dock Addition from the Westerly Side Lot Line Projection	15 ft.	9.5 ft.	5.5 ft.
B	4.1.7 and 4.1.7.12 a.	Maximum Cumulative Dock Width	15 ft.	24.5 ft.	9.5 ft.

A key map of the subject property and the applicants' site plan and any drawings are included in this notice.

TAKE FURTHER NOTICE that this public hearing will be held in a hybrid forum with electronic ZOOM participation, and in-person format for those who wish to attend in person. The meeting will be held in the **Council Chambers, Municipal Office, 1 Bailey Street, Port Carling, Ontario, and will commence**

at 9:00 a.m. More information about viewing and/or participating in the ZOOM hearing is included in this Notice and can be found on our website at www.muskokalakes.ca.

ADDITIONAL INFORMATION relating to the proposed variance application is available from the Planning Department weekdays between 8:15 a.m. and 4 p.m. at the Municipal Office, or at planning@muskokalakes.ca or by phone at (705)765-3156, by Fax at (705) 765-6755, or by mail at The Corporation of the Township of Muskoka Lakes, Box 129, Port Carling, Ontario, P0B 1J0.

Please quote the file number noted above.

YOU OR YOUR REPRESENTATIVE are entitled to participate in this public hearing and make verbal representation and/or make written representation prior to the meeting. Comments can be submitted by emailing planning@muskokalakes.ca or by regular mail or the Municipal Office drop box outside the main entrance to the Municipal Office located at 1 Bailey St., Port Carling.

IF YOU WISH TO SPEAK to the Committee of Adjustment at the hearing by electronic participation, please contact planning@muskokalakes.ca by 9:00 a.m. on the regular business day preceding the scheduled hearing.

FAILURE TO PARTICIPATE IN HEARING: If you do not participate in the hearing it may proceed in your absence and, except as otherwise provided in the Planning Act, you will not be entitled to any further notice in the proceedings.

NOTICE OF DECISION: If you wish to be notified of the decision of the Committee of Adjustment in respect of this application, you must submit a written request to the Committee of Adjustment.

NO ONE OTHER THAN the applicant, the municipality, certain public bodies and the minister may file an appeal of the decision of the Committee of Adjustment in respect of the proposed variance. If they do not make written submission to the Secretary Treasurer before the variance is approved or refused, then the Ontario Land Tribunal may dismiss the appeal.


THE HEARING will be live-streamed on the Township's live webcast at: www.muskokalakes.ca If the live webcast fails, the meeting recording will be posted at: <https://muskokalakes.civicweb.net/Portal/>

PLEASE NOTE: THE COMMITTEE OF ADJUSTMENT IS A JUDICIAL BODY WHICH MAKES DECISIONS SOLELY ON INFORMATION GATHERED AS A COMMITTEE. COMMITTEE MEMBERS ARE NOT TO BE CONTACTED PRIOR TO THE HEARING DATE TO AVOID A CONFLICT OF INTEREST.

Dated this 30th day of June, 2023.

"Original Signed by K. Bavington"
Kitty Bavington,
Secretary-Treasurer
Committee of Adjustment

KEY MAP

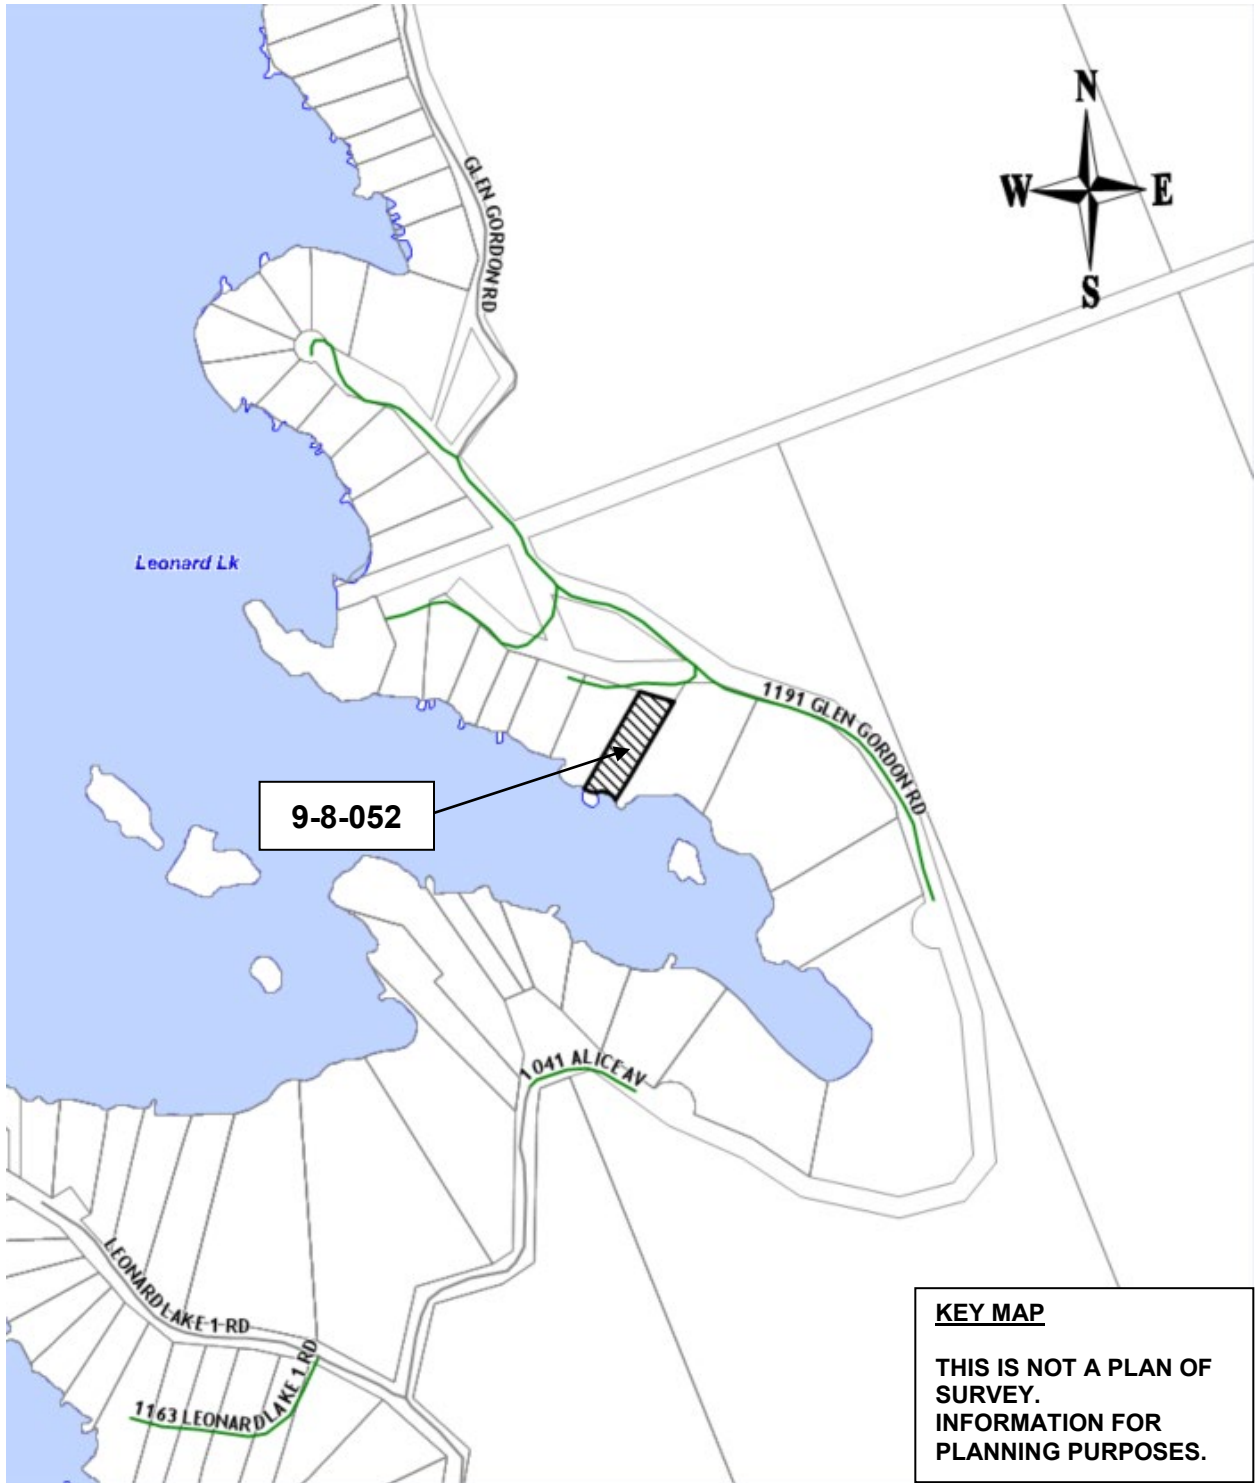

PROPOSED SITE PLAN

NOT TO SCALE




KEY PLAN (N.T.S)
DERIVED FROM MUSKOKA GEOHUB

LOT 18 CON 8 WR4


AREA STATISTICS:

LOT AREA:	30,847.4 SQ. FT.
AREA WITHIN 200FT:	20,525.4 SQ. FT.
DWELLING AREA:	1022 SQ. FT.
ACCESSORY BLDGS:	252 SQ. FT.
PROPOSED ADDITION:	240 SQ. FT.

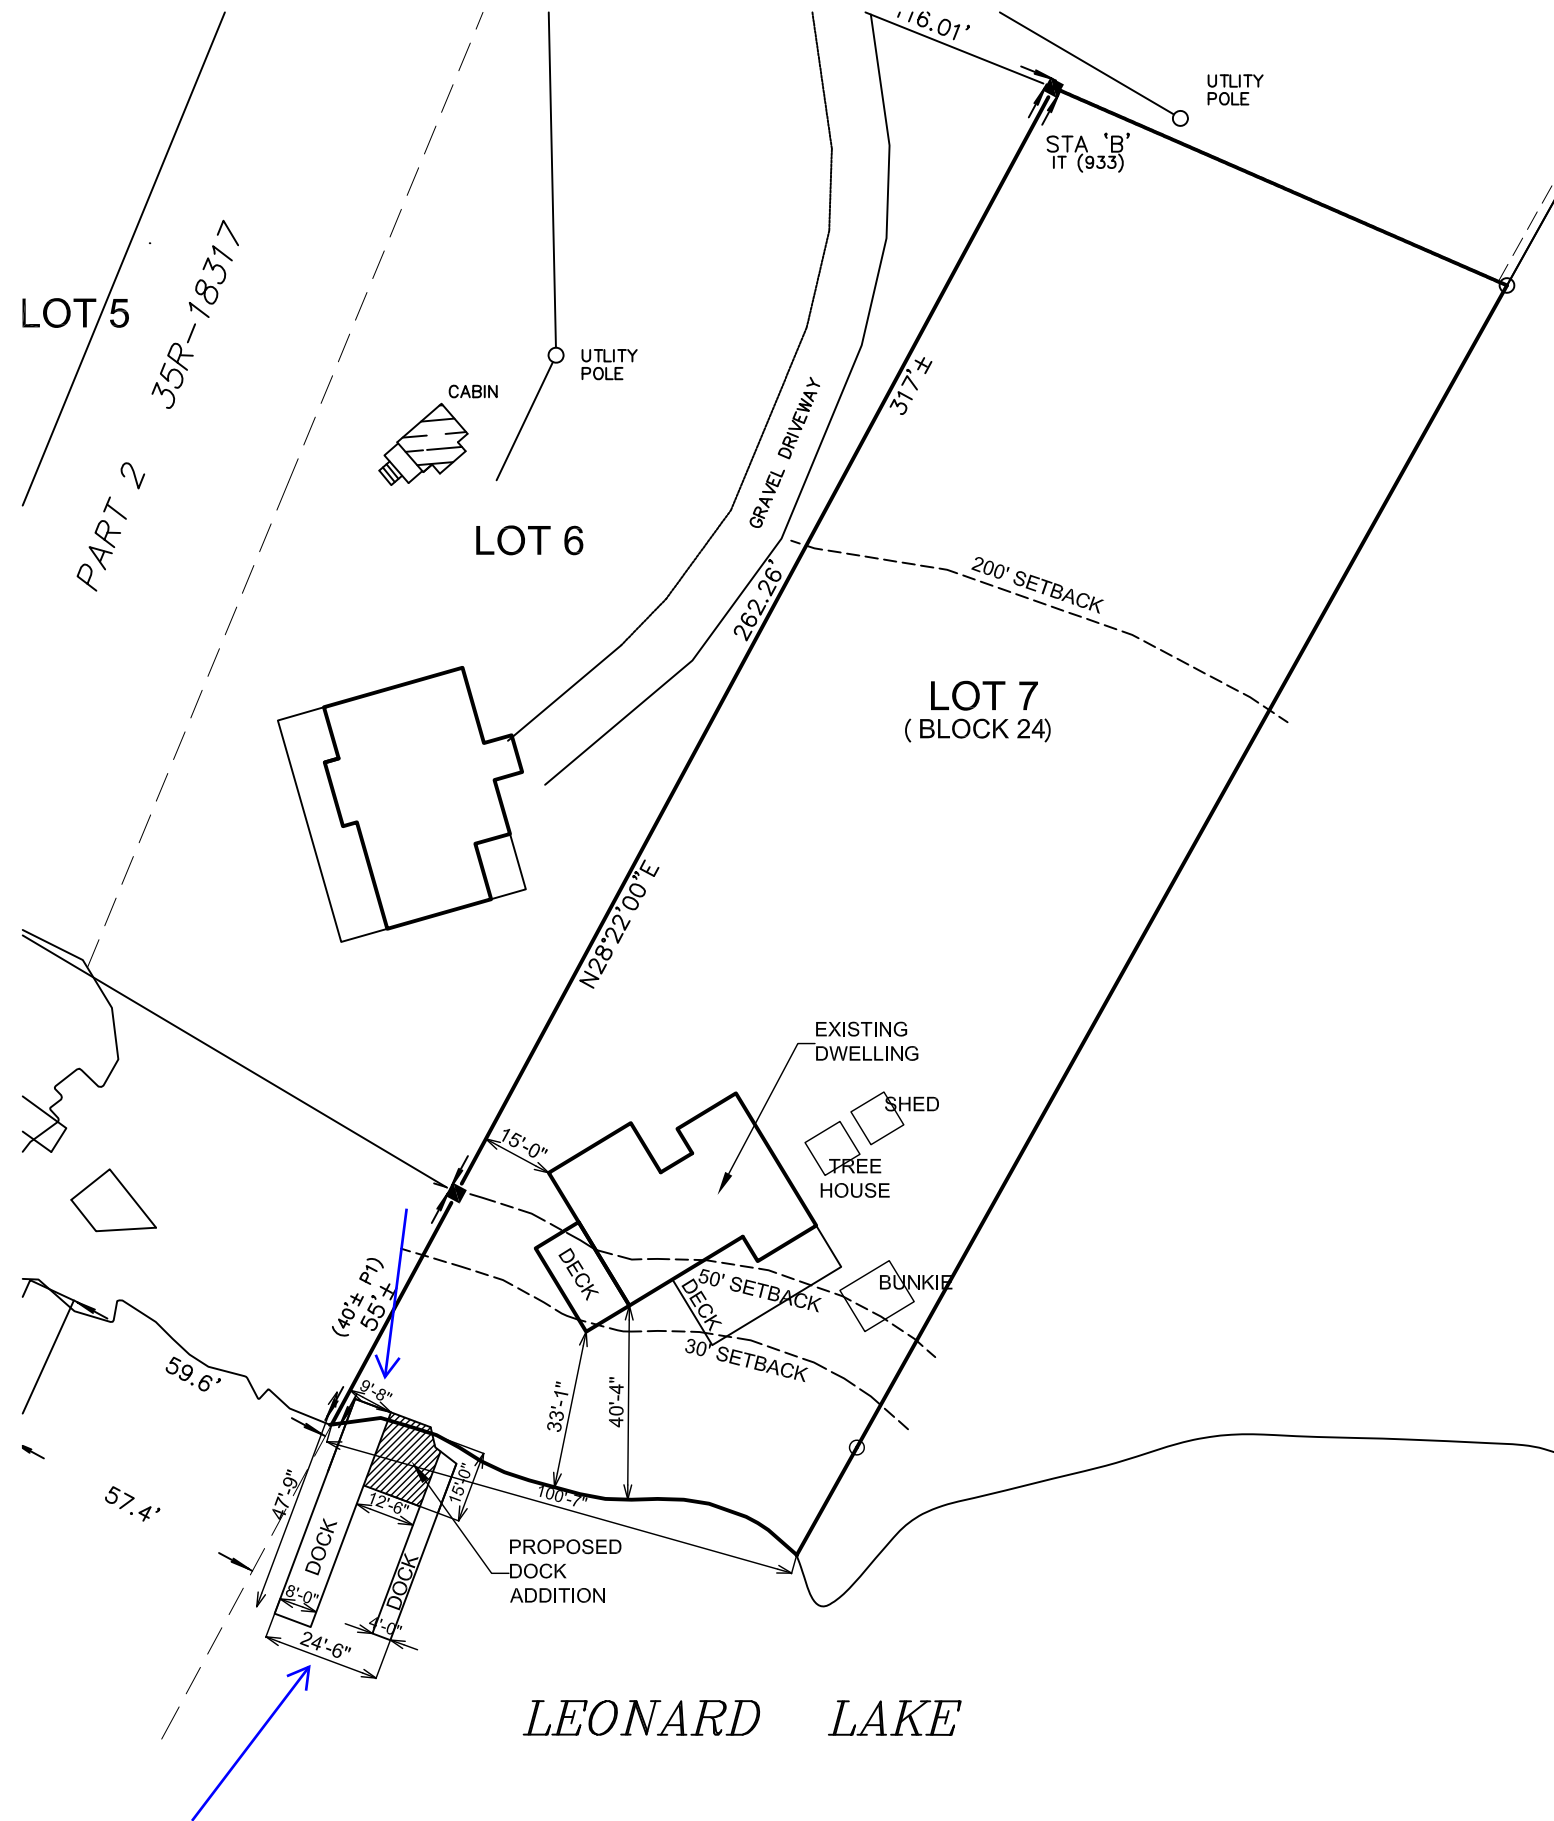

GENERAL NOTES

1. Do not scale drawings.
2. Should there appear to be any discrepancies, please contact designers prior to proceeding.
3. All materials and installation methods shall adhere to the Ontario Building Code.
4. Any substitutions shall be approved by the designers prior to proceeding with any work.

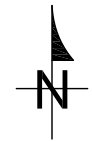


P 705.765.5428 F 705.765.1334
167 Medora Street
Port Carling ON P0B 1J0
BCIN # 27436



I REVIEW AND TAKE RESPONSIBILITY FOR THE DESIGN WORK ON BEHALF OF A FIRM REGISTERED UNDER SUBSECTION 2.17.4. OF THE BUILDING CODE. I AM QUALIFIED, AND THE FIRM IS REGISTERED, IN THE APPROPRIATE CLASSES/CATEGORIES.

INDIVIDUAL BCIN: 22334
FIRM BCIN: 27436

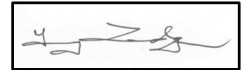

TERRY LEDGER

CONSULTANTS

CHAN/POOLE COTTAGE

11-1191 GLEN GORDON RD.
TOWNSHIP OF
MUSKOKA LAKES

MARK	DATE	DESCRIPTION
SCALE: 1"= 40'-0"		
PROJECT NO: TL-21-2491HU		
CAD DWG FILE: HUNKELER-SITE		
DRAWN BY: TERRY LEDGER		
CHECKED BY:		

SHEET TITLE

**SITE
PLAN**

A0