

Tender Addendum 1

File	Tender	Tender No.
225023	Windermere Community Centre Kitchen System Upgrades	T-2025-07

Date	Owner
September 2, 2025	Township of Muskoka Lakes

Message to Bidder

Instructions to Bidders Section A, Part 1 – Tender closing date to be revised to September 9, 2025 at 2:00 pm.

Instructions to Bidders Section A, Part 2 – TC-1 – subsection 1.7 – Electronic bid submissions are allowable.

Instructions to Bidders Section A, Part 2 – TC-2 – Remove this article, tender deposit not required.

Instructions to Bidders All ESA costs are to be included in bid.

Attachments Please find attached the following revised drawings:

- Drawing M.1 – Mechanical Schedules, Legend, Specifications, and Details, Issued for Addendum 1.
- Drawing E.3 – Electrical Specifications, Issued for Addendum 1.

Terms & Conditions

Except as to and to the extent that they are amended by the foregoing, all terms and conditions of the tender document remain in full force and effect, and time shall be of the essence.

Directions to Bidder

The Bidder shall:

1. sign this Addendum in the space provided below and submit this Addendum to the Owner in the same envelope as the Tender
2. enter this Addendum number in the Tender Form

Signature of Bidder

Date

I:\2025 Projects\225023 - Windermere Community Centre Kitchen, TML\Documents\Tenders\Tender Addendum 1.docx

MECHANICAL LEGEND	
DOMESTIC COLD WATER PIPING	-----
DOMESTIC HOT WATER PIPING	-----
DOMESTIC HOT WATER RE--CIRCULATION PIPING	-----
NATURAL GAS PIPING PIPING	=====
SANITARY WASTE PIPING (ABOVE GRADE)	=====
SANITARY WASTE PIPING (BELOW GRADE)	-----
SANITARY VENT	-----
STORM WASTE PIPING (ABOVE GRADE)	=====
STORM WASTE PIPING (BELOW GRADE)	-----
HEATING WATER SUPPLY PIPING	-----
HEATING WATER RETURN PIPING	-----
REFRIGERANT LIQUID PIPING	-----
REFRIGERANT SUCTION PIPING	-----
FUEL OIL SUPPLY	-----FOS-----
FUEL OIL RETURN	-----FOR-----
FUEL OIL FILL	-----FOF-----
FUEL OIL VENT	-----FOV-----
PIPE UP	-----○-----
PIPED DOWN	-----C-----
CONNECT TO EXISTING	-----C-----
AIR FLOW DIRECTION	-----←-----
FLEXIBLE DUCT CONNECTOR	-----+-----
EXISTING SERVICES OR EQUIPMENT	-----[]-----
EXISTING SERVICES OR EQUIPMENT TO BE REMOVED	-----[]-----
CIRCULATOR	-----⊙-----
FLOOR DRAIN C/W TRAP	-----⊙-----
SUPPLY DUCT UP/DOWN	-----⊗-----
RETURN DUCT UP/DOWN	-----⊘-----
EXHAUST DUCT UP/DOWN	-----⊗-----
ROUND DUCT UP/DOWN	-----⊙-----
FIRE DAMPER	FD-----
BALANCING DAMPER	BD-----
MOTORIZED DAMPER	MD-----
FIRE EXTINGUISHER (FE-1), 6--LITER A/K	-----⊗-----
MANUAL PULL STATION	MS-----
THERMOSTAT	-----⊙-----
THERMOSTAT HEATING (DIV. 16)	-----⊙-----
THERMOSTAT VENTILATION (DIV. 16)	-----⊙-----
HUMIDISTAT (DIV. 16)	-----⊙-----
CARBON DIOXIDE SENSOR	-----⊙-----
CARBON MONOXIDE SENSOR	CO-1-----
NITROGEN DIOXIDE SENSOR	NO2-1-----
CONTROL WIRE (LOW VOLTAGE)	-----⊙-----
DRAWING REVISION	-----⊙-----
SYMBOL INDICATES A REVISION, (# DENOTES REVISION NUMBER)	-----⊙-----
SYMBOL INDICATES MODIFICATION OR NEW WORK	-----⊙-----
SYMBOL INDICATES NOTE DEMOLITION/ REMOVAL WORK	-----⊙-----
DETAIL NUMBER	2-----
SHEET NUMBER/ DETAIL LOCATION	M.2-----
TYPE OF DIFFUSER/GRILLE OR (SEE SCHEDULE)	-----X-----
SIZE-- IMPERIAL: IN. METRIC: MM	-----X-----
AIR FLOW-- IMPERIAL: CFM, METRIC: L/S	-----X-----

MASTER MECHANICAL LEGEND
ALL SYMBOLS/DEVICES LISTED MAY NOT APPLY

- GENERAL SPECIFICATIONS:
- REVIEW WORK AREA AND READ DRAWINGS IN CONJUNCTION WITH ALL DISCIPLINES BEFORE COMMENCING WORK. NOTIFY ENGINEER OF ANY DISCREPANCIES BETWEEN PLANS AND POTENTIAL ISSUES ON WORK-SITE. NO ADDITIONAL PAYMENTS WILL BE MADE RELATED TO CLAIMS FOR ITEMS THAT WOULD HAVE BEEN APPARENT IF THE WORK AREA AND ALL PLANS WERE REVIEWED PRIOR TO PRICING THE WORKS.
 - THE GENERAL CONTRACTOR SHALL OBTAIN AND PAY FOR NECESSARY PERMITS PERTAINING TO THE INSTALLATION OF THEIR WORK AND PROVIDE ANY CERTIFICATES AND SIGN-OFFS AS CIRCUMSTANCES REQUIRE.
 - WORK SHALL BE PERFORMED IN ACCORDANCE WITH THE LATEST EDITION OF THE ONTARIO BUILDING CODE, ONTARIO FIRE CODE, OCCUPATIONAL HEALTH AND SAFETY ACT, AND AUTHORITIES HAVING JURISDICTION. MATERIALS SHALL CONFORM TO THE LATEST EDITION OF THE CANADIAN STANDARDS ASSOCIATION, AND AUTHORITIES HAVING JURISDICTION. STANDARDS SET OUT IN DESIGN DRAWINGS SHALL NOT BE REDUCED BY CONFORMANCE TO APPLICABLE CODES AND STANDARDS. MAKE ALL MINOR MODIFICATIONS AS REQUIRED BY AUTHORITIES HAVING JURISDICTION AT NO COST TO THE OWNER.
 - SUBMIT ELECTRONIC SHOP DRAWINGS FOR EQUIPMENT LISTED ON THE SCHEDULES FOR REVIEW PRIOR TO ORDERING. REVIEW OF SHOP DRAWINGS DOES NOT RELIEVE THE CONTRACTOR OF THEIR RESPONSIBILITIES TO PROVIDE A COMPLETE WORKING SYSTEM CONSISTENT WITH THE INTENT OF THE DESIGN DRAWINGS. CONTRACTOR SHALL REVIEW DESIGN DRAWINGS, EQUIPMENT SCHEDULES AND SHOP DRAWINGS FOR ERRORS AND OMISSIONS AND ELEMENTS RELATING TO WORKS/ASSEMBLY ON-SITE.
 - AT THE COMPLETION OF THE PROJECT THE CONTRACTOR SHALL PROVIDE MARKED UP RECORD DRAWINGS AND OPERATION AND MAINTENANCE MANUALS. THE FIRST PAGE OF THE OPERATION AND MAINTENANCE MANUAL SHALL BE A TYPE WRITTEN DOCUMENT EXPLAINING THE DETAILED MAINTENANCE REQUIREMENTS AND SCHEDULE FOR THE SYSTEM AND ANY OTHER INFORMATION THAT IS SPECIFIC TO THIS PROJECT. GENERIC OPERATIONS AND MAINTENANCE MANUALS WITH NO PROJECT SPECIFIC INFORMATION WILL NOT BE ACCEPTED.
 - PROVIDE TRAINING FOR THE OPERATOR OR OWNER'S REPRESENTATIVE. PROVIDE COMMISSIONING SERVICES AS REQUIRED.
 - LABEL ALL EQUIPMENT, PIPING, CONDUIT ETC.
 - THE CONTRACTOR IS RESPONSIBLE FOR STORAGE AND SECURITY OF MATERIALS AND EQUIPMENT ON THE JOB SITE.
 - THE OWNER'S PROPERTY MUST BE KEPT IN TIDY CONDITION, PROMPTLY REMOVE GARBAGE FROM THE SITE. CLEAN WORK AREA PRIOR TO ALL INSPECTIONS AND KEEP SITE IN A SAFE CONDITION.
 - DESIGN DRAWINGS ILLUSTRATE THE GENERAL LAYOUT OF THE WORK ONLY. COORDINATE THE INSTALLATION OF WORK WITH OTHER TRADES. THE CONTRACTOR SHALL BE RESPONSIBLE FOR THE PROPER LAYOUT OF EQUIPMENT AND MATERIALS AND ENSURING THERE ARE NO INTERFERENCES WITH OTHER SYSTEMS.
 - THE CONTRACTOR SHALL BE RESPONSIBLE FOR CUTTING AND PATCHING REQUIRED FOR THE INSTALLATION OF THEIR WORK.
 - EQUIPMENT SHALL BE INSTALLED, STARTED, TESTED, AND ADJUSTED AS PER THE MANUFACTURERS' INSTRUCTIONS, AND AS NECESSARY TO ENSURE OPTIMUM PERFORMANCE. EQUIPMENT SHALL BE INSTALLED TO ALLOW FOR EASY ACCESS AND MAINTENANCE.
 - THE CONTRACTOR SHALL GUARANTEE WORK PERFORMED UNDER THIS CONTRACT FOR A PERIOD OF ONE (1) YEAR FROM THE DATE OF SUBSTANTIAL COMPLETION. ENSURE THAT ALL EQUIPMENT IS WARRANTED BY THE MANUFACTURER FOR A MINIMUM OF ONE (1) YEAR FROM THE DATE OF SUBSTANTIAL COMPLETION.
 - MATERIALS AND EQUIPMENT SHALL BE NEW, TOP QUALITY AND SPECIFICATION GRADE, EXCEPT WHERE NOTED OTHERWISE.
 - THIS SPECIFICATION SHALL BE CONSIDERED TO BE THE BASE BID SPECIFICATION AND CONTRACTORS MUST CARRY THE BASE BID MANUFACTURERS IN THEIR QUOTATION, ALTERNATE MANUFACTURERS OF EQUIPMENT CAN ONLY BE OFFERED AS PROPOSED ALTERNATES WITH THE CORRESPONDING PRICE REDUCTIONS PASSED ON TO OWNER.
 - THE CONTRACTOR SHALL NOT WELD TO OR MAKE A HOLE IN A STRUCTURAL MEMBER WITHOUT REVIEW FROM THE STRUCTURAL ENGINEER. ATTACHMENTS TO STRUCTURAL MEMBERS SHALL BE MADE WITH SUITABLE CLAMPS OR CLIPS.
 - THE GENERAL CONTRACTOR SHALL PROVIDE ALL OPENINGS AND REINFORCEMENT FRAMING AS REQUIRED.
 - ALL MATERIALS IN CEILING SPACE USED FOR RETURN AIR PLENUM MUST BE PLENUM RATED.
 - CONFIRM FIRE SEPARATIONS WITH ARCHITECTURAL DRAWINGS AND GENERAL CONTRACTOR. ALL PENETRATIONS THROUGH FIRE SEPARATIONS SHALL BE FITTED WITH EXPANSION SLEEVES AND ULC CERTIFIED FIRE STOPPING. ACCEPTABLE MATERIAL: HILTI OR APPROVED EQUIVALENT.
 - THE OWNER RESERVES THE RIGHT TO MAKE MINOR ALTERATIONS TO THE LOCATION OF EQUIPMENT ETC AT NO ADDITION TO THE CONTRACT AMOUNT.
 - THESE DRAWINGS ARE SCHEMATIC IN NATURE AND INTENDED TO SERVE AS A GUIDE SHOWING QUANTITIES AND GENERAL ARRANGEMENTS AND ARE NOT NECESSARILY WORKING DRAWINGS FROM WHICH MEASUREMENTS CAN BE TAKEN, EXCEPT WHERE DIMENSION FIGURES ARE SPECIFICALLY SHOWN. INFORMATION INVOLVING ACCURATE MEASUREMENTS OF BUILDING SHALL BE TAKEN FROM ARCHITECTURAL BUILDING DRAWINGS OR FROM THE SITE.
 - MAINTAIN ADEQUATE LIABILITY INSURANCE TO PROTECT OWNER AND ALL CONTRACTORS.
 - TEMPORARY LIGHTING AND POWER FOR CONSTRUCTION BY GENERAL CONTRACTOR.
 - ALL EQUIPMENT, PIPING, CONDUIT, WIRING, JUNCTION BOXES, HARDWARE, ETC. INSTALLED IN OPEN CEILING SPACES SHALL BE INSTALLED IN AN INCONSPICUOUS AND AESTHETICALLY PLEASING MANNER UP TO THE SOLE DISCRETION OF THE OWNER AND ENGINEER. ALL EQUIPMENT, PIPING, CONDUIT, WIRING, JUNCTION BOXES, HARDWARE SHALL BE INSTALLED IN CHASES, ABOVE ADJACENT CEILINGS WHERE POSSIBLE.
 - SUITABLE ACCESS DOORS MUST BE PROVIDED WHERE NECESSARY TO ACCESS VALVES, JUNCTION BOXES, CLEAN OUTS, FIRE DAMPERS, AND OTHER EQUIPMENT AND APPURTENANCES. ALL ITEMS REQUIRING ACCESS PANELS ARE NOT NECESSARILY SHOWN, CARRY A REASONABLE COST ALLOWANCE. COORDINATE EXACT LOCATION OF COMPONENTS REQUIRING ACCESS AND SELECT SIZES WHICH ARE SUITABLE FOR MAINTENANCE.
 - FOR GYPSUM WALLS AND CEILINGS IN OCCUPIED AREAS, PROVIDE CONCEALED DOORS WITH 5/8" RECESS TO RECEIVE DRYWALL, ACCEPTABLE MATERIAL: FOR STANDARD CEILINGS AND WALLS ACUDOR DW-5015 OR EQUIVALENT, FOR 90 MINUTE FIRE RATING ACUDOR FW(C)-5015 OR EQUIVALENT; FOR GREATER RATING, CONTACT ENGINEER AND ARCHITECT.
 - FOR GYPSUM, PLASTER, MASONRY OR TILE WALLS AND CEILINGS IN UTILITY AND STORAGE AREAS, PROVIDE UNIVERSAL FLUSH ACCESS DOOR, ACCEPTABLE MATERIAL: FOR STANDARD CEILINGS AND WALLS ACUDOR UF-5000 OR EQUIVALENT, FOR 90 MINUTE FIRE RATING ACUDOR FW-5050, FOR GREATER RATING, CONTACT ENGINEER AND ARCHITECT.
 - PAY FOR AND COORDINATE ALL UTILITY LOCATES AS REQUIRED.
 - PROVIDE WATER--PROOFING OF BUILDING OPENINGS RELATED TO THE WORK OF ALL TRADES.

HVAC GRILLES SCHEDULE					
TAG	SERVICE	DESCRIPTION	MAKE	MODEL	ACCESSORIES/REMARKS
DG-1	TRANSFER AIR	DOOR GRILLE	E. H. PRICE	ATG1	ALUMINUM, SIGHT PROOF, 24"W X 20"H (PROVIDES LOW NOISE LEVELS AT 300CFM)

FIRE SUPPRESSION SYSTEM SCHEDULE				
DESCRIPTION	MODEL	QTY	ACCESSORIES/REMARKS	
RESTAURANT COOKING AREA FIRE SUPPRESSION SYSTEM	BUCKEY	1	BFR-10 FIRE SUPPRESSION AGENT CYLINDER, MB-2 CYLINDER MOUNTING BRACKET, BFR-VLY VALVE, BFR-DAK DISCHARGE ADAPTER KIT, BFR-SAP VALVE CAP, SMW2 MECHANICAL SYSTEM RELEASING MODULE (TWO MS-DPDT MICROSWITCHES INCLUDED), SM-120 SOLENOID MONITOR, RPS-M REMOTE MECHANICAL PULL STATION, FLB-1 FUSIBLE LINK BRACKET, BFR-SC-100 SHIELDED CABLE INTERFACE, 2x N-1HP NOZZLE, 2x N-SA SWIVEL NOZZLE ADAPTOR	


RANGE HOOD SCHEDULE									
TAG	MAKE	MODEL	DIMENSIONS (IN)			EXHAUST			ACCESSORIES/REMARKS
			LENGTH	WIDTH	HEIGHT	VOLUME (CFM)	E.S.P. (IN WC)	COLLAR SIZE (IN)	
RH-1	BROAN	BCS330WWC	19- $\frac{5}{8}$	29- $\frac{7}{8}$	6	240	0.12	7	COLOUR: WHITE, C/W GOOSENECK EXHAUST EXCLUDING INTEGRAL BACK DRAFT DAMPER, INSULATED DUCT TO EXTERIOR
RH-2	BROAN	BCS330WWC	19- $\frac{5}{8}$	29- $\frac{7}{8}$	6	240	0.12	7	COLOUR: WHITE, C/W GOOSENECK EXHAUST EXCLUDING INTEGRAL BACK DRAFT DAMPER, INSULATED DUCT TO EXTERIOR

- KITCHEN VENTILATION SYSTEM SPECIFICATIONS:
- THE PROPOSED KITCHEN EXHAUST HOOD LAYOUT SHOWN ON THESE DRAWINGS ARE TO ILLUSTRATE THE GENERAL LOCATIONS OF EQUIPMENT; A KITCHEN EXHAUST HOOD AIRFLOW RATE OF 100 CFM MINIMUM, 300 CFM MAXIMUM WAS USED TO ESTABLISH THE EXHAUST FAN AND MAKE-UP AIR SIZING; THIS AIRFLOW RATE SHALL BE CONFIRMED WITH THE FINAL KITCHEN LAYOUT PROVIDED BY THE OWNER. THE CONTRACTOR SHALL PROVIDE A COMPLETE SET OF SHOP DRAWINGS FOR SYSTEM INSTALLATION INCLUDING HOOD, EXHAUST DUCT, APPLIANCES, FIRE DETECTORS, PIPING, NOZZLES, APPLIANCE SHUTOFF DEVICES, FIRE SUPPRESSION AGENT STORAGE CONTAINERS AS WELL AS CONTROLLER, AND MANUAL ACTIVATION DEVICES. SHOP DRAWINGS AND CERTIFICATION THAT INSTALLATION IS IN COMPLIANCE WITH THE TERMS OF THE LISTING AND MANUFACTURER'S INSTRUCTIONS SHALL BE SUBMITTED TO OWNER'S ENGINEER AND AHJ FOR REVIEW. SHOP DRAWINGS TO BE IDENTIFIED AS PRE-ENGINEERED AND UL300 LISTED, OR BE STAMPED BY A PROFESSIONAL ENGINEER.
 - WORK MUST BE PERFORMED IN ACCORDANCE WITH THE LATEST EDITION OF THE ONTARIO ELECTRICAL SAFETY CODE, ONTARIO BUILDING CODE, ONTARIO FIRE CODE, OCCUPATIONAL HEALTH AND SAFETY ACT, AND LOCAL CODES.
 - HOODS SHALL BE SIZED TO MATCH THE WIDTH OF THE KITCHEN RANGE.
 - PROVIDE MESH FILTER IN HOOD.
 - PROVIDE DUCTWORK WITH SLOPE BACK TO THE KITCHEN HOOD, DO NOT INSTALL WITH DIPS OR TRAPS, DO NOT TIE IN WITH ANY OTHER DUCTWORK SYSTEMS.
 - PROVIDE ALL DUCT SUPPORT HARDWARE, JOINTS (TELESCOPING AND BELL JOINTS) ETC.
 - PROVIDE SUITABLE WEATHER PROTECTIVE COATING ON ALL DUCTWORK ON EXTERIOR OF BUILDING.
 - LIGHTING UNITS IN HOODS SHALL BE LISTED FOR USE IN COOKING APPLICATIONS AND SHALL BE WIRED THROUGH KITCHEN HOOD CONTROL PANEL.
 - PROVIDE READILY ACCESSIBLE MEANS OF MANUAL ACTIVATION LOCATED AT 48" (1.2m) AFF. DEVICE SHALL BE INDEPENDENT OF AUTOMATIC ACTIVATION AND SHALL BE FULLY MECHANICAL. POST INSTRUCTIONS FOR MANUAL OPERATION OF FIRE EXTINGUISHING SYSTEM IN CONSPICUOUS LOCATION IN KITCHEN.
 - PROVIDE K-CLASS PORTABLE FIRE EXTINGUISHER IN COOKING AREAS TO NFPA 10.
 - AUTOMATIC FIRE EXTINGUISHING SYSTEMS SHALL COMPLY WITH UL300 AND NFPA 12, NFPA 13, NFPA 17, NFPA 17A.
 - INSTALLATION AND CLEARANCES OF ALL KITCHEN COOKING APPLIANCES SHALL BE TO MANUFACTURER'S RECOMMENDATIONS.
 - PROVIDE SHUNT TRIP BREAKERS FOR ALL ELECTRICAL COOKING APPLIANCES.
 - WHERE OCCUPANCY IS PROTECTED BY FIRE ALARM SYSTEM, PROVIDE SUPERVISORY EQUIPMENT/SIGNAL TO FIRE ALARM SYSTEM WHERE ELECTRICAL POWER IS REQUIRED TO OPERATE AUTOMATIC FIRE EXTINGUISHING SYSTEM.
 - VENTILATION NORMAL OPERATION.
 - UPON VENTILATION SYSTEM START SIGNAL FROM THE KITCHEN HOOD MANUFACTURER SUPPLIED SWITCH, THE INTERNAL EXHAUST FAN SHALL TURN ON.
 - UPON VENTILATION SYSTEM STOP SIGNAL FROM THE KITCHEN HOOD MANUFACTURER SUPPLIED SWITCH, THE INTERNAL EXHAUST FAN SHALL TURN OFF.
 - UPON ACTIVATION OF FIRE EXTINGUISHING SYSTEM THE FOLLOWING SEQUENCE OF OPERATION SHALL OCCUR:
 - ALL SOURCES OF FUEL AND POWER SHALL BE AUTOMATICALLY SHUT OFF TO THE RANGE. ALL SHUTOFF DEVICES SHALL REQUIRE A MANUAL RESET.
 - AUDIBLE AND/OR VISUAL ALARM SHALL BE ACTIVATED.
 - WHERE OCCUPANCY IS PROTECTED BY FIRE ALARM SYSTEM, ACTIVATION SHALL TRIGGER FIRE ALARM SYSTEM BY MEANS OF MICRO-SWITCH.
 - EF-1 SHALL START RUNNING AFTER EXTINGUISHING SYSTEM HAS BEEN ACTIVATED UNLESS FAN SHUTDOWN IS REQUIRED BY A LISTED COMPONENT IN THE AUTOMATIC FIRE EXTINGUISHING SYSTEM.
 - ELECTRICAL POWER TO BOTH ELECTRICAL COOKING APPLIANCES SHALL BE TURNED OFF VIA A SHUNT TRIPPER FROM THE FIRE SUPPRESSION CONTROLLER.


- HVAC SPECIFICATIONS
- DUCTS SHALL BE FABRICATED AND INSTALLED IN ACCORDANCE WITH THE LATEST EDITION OF THE ONTARIO BUILDING CODE, ONTARIO FIRE CODE, AND THE ASHRAE AND SMACNA STANDARDS.
 - PROVIDE PRE-DEMOLITION AIRFLOW MEASUREMENTS ON EXISTING FAN. MEASUREMENTS TO INCLUDE AMPERAGE READING ON FAN MOTOR. SUBMIT PRE-DEMOLITION MEASUREMENTS TO CONSULTANT FOR REVIEW. THE BALANCING MUST BE PERFORMED BY AN INDEPENDENT, NEBB CERTIFIED FIRM, SPECIALIZING IN THIS WORK. THE MECHANICAL CONTRACTOR SHALL TURN OVER THE BALANCING REPORT PRIOR TO SUBSTANTIAL COMPLETION BEING AWARDED.
 - VOLUME DAMPERS MUST BE INSTALLED IN THE AIR DISTRIBUTION SYSTEMS AS SHOWN ON THE DRAWINGS AND AS NECESSARY TO ALLOW PROPER BALANCING.
 - DUCTS MUST BE SEALED TO PREVENT AIR LEAKAGE. SEAL TO SMACNA AND ASHRAE 90.1 STANDARDS. FOR UNPAINTED DUCTS INSTALLED IN VISIBLE SPACES, THE DUCT MASTIC IS TO BE APPLIED TO THE INTERIOR OF DUCT JOINTS AND PENETRATIONS AND SHALL NOT BE VISIBLE FROM THE EXTERIOR. MASTIC MAY BE APPLIED TO THE EXTERIOR OF DUCTS ONLY IN AREAS WHERE IT IS NOT VISIBLE TO OCCUPANTS. EXPOSED MASTIC SHALL BE PAINTABLE AND IS TO BE APPLIED NEATLY WITH THE EXCESS REMOVED. REFER TO ARCHITECT'S DRAWINGS TO CONFIRM WHETHER OR NOT DUCTS ARE TO BE PAINTED.
 - FIRE DAMPERS MUST HAVE A FIRE PROTECTION RATING IN ACCORDANCE WITH THE NFPA AND MUST BEAR THE ULC LABEL. USE DYNAMIC AND TYPE 'B' FIRE DAMPERS ONLY.
 - INSTALL FOIL BACKED VAPOUR RETARDANT FIBERGLASS INSULATION WITH JOINTS AND SEAMS SEALED WITH 3" FOIL TAPE ON DUCTS ACCORDING TO THE INSTALLED LOCATION:
 - R-8 INSULATION ON THE NEW EXHAUST DUCT LOCATED IN THE ATTIC SPACE.
 - DUCT SIZES ARE SHOWN IN INCHES AND DO NOT INCLUDE FOR INTERNAL INSULATION.
 - PIPES AND EQUIPMENT MUST BE INSTALLED SO AS TO MINIMIZE THE TRANSFER OF VIBRATION TO THE BUILDING AND ALSO TO ALLOW FOR EXPANSION AND CONTRACTION AS NECESSARY.
 - EQUIPMENT SHALL BE ASHRAE 90.1 COMPLIANT.
 - LINE VOLTAGE STARTERS, CONTROLS AND EQUIPMENT SAFETY SWITCHES SHALL BE SUPPLIED BY MECHANICAL CONTRACTOR AND INSTALLED BY ELECTRICAL CONTRACTOR UNLESS OTHERWISE NOTED ON THE ELECTRICAL DESIGN DRAWINGS. LOW VOLTAGE STARTERS AND CONTROLS SHALL BE SUPPLIED AND INSTALLED BY MECHANICAL CONTRACTOR.
 - ELECTRICAL WIRING, CONDUIT, JUNCTION BOXES, BACK BOXES, MOUNTING HARDWARE ETC. ABOVE 24V TO BE SUPPLIED AND INSTALLED BY ELECTRICAL CONTRACTOR. CONTROLS WIRING, CONDUIT, JUNCTION BOXES, BACK BOXES, MOUNTING HARDWARE ETC. 24V AND BELOW TO BE INSTALLED BY MECHANICAL CONTRACTOR (MECHANICAL CONTRACTOR MAY SUB-CONTRACT THIS WORK TO ELECTRICAL CONTRACTOR).
 - THERMOSTATS AND CONTROLLERS INTENDED TO BE OPERATED BY THE OCCUPANT AND LOCATED IN A BARRIER-FREE PATH OF TRAVEL. SHALL BE MOUNTED 4FT (1200MM) ABOVE THE FINISHED FLOOR.
 - THE MECHANICAL CONTRACTOR SHALL INSTALL PIPE WITH SLEEVES IN ORDER TO PREVENT CONTACT WITH CONCRETE, MASONRY OR SIMILAR MATERIALS.
 - ROOF CURBS AND FLASHINGS ARE TO BE SUPPLIED BY THE MECHANICAL CONTRACTOR, INSTALLED BY THE GENERAL CONTRACTOR/ROOFER.
 - ALL EQUIPMENT SHALL BE INSTALLED IN SUCH A MANNER THAT MANUFACTURER'S RECOMMENDED CLEARANCES ARE MAINTAINED. THE CONTRACTOR SHALL LAY OUT THE WORK BASED ON THE MANUFACTURER'S RECOMMENDED CLEARANCES AND ADVISE ENGINEER IMMEDIATELY IF ANY SITE CONDITIONS NEGATIVELY AFFECT THE PROPER INSTALLATION OF ALL EQUIPMENT.
 - ALL DOOR UNDERCUTS INDICATED SHALL BE MIN 3/4". COORDINATE WITH GENERAL CONTRACTOR.
 - THIS CONTRACTOR SHALL REVIEW AND CONFIRM ALL EXISTING INDOOR METALLIC PIPING SYSTEMS ARE BONDED. PROVIDE BONDING FOR ALL NEW INDOOR METALLIC PIPING SYSTEMS AND EXISTING SYSTEMS WITHOUT PROPER BOND. BONDING SHALL BE INSTALLED TO THE REQUIREMENTS OF DESC 10-406. THE GENERAL CONTRACTOR SHALL DETERMINE IF BONDING IS BY MECHANICAL OR ELECTRICAL.
 - CLEAN ALL EXISTING GRILLES AND DIFFUSERS WHICH ARE SHOWN TO REMAIN.
 - DUCTWORK CONNECTIONS TO OUTDOOR AIR HANDLING UNITS WITH HORIZONTAL DISCHARGE SHALL BE EQUIPPED WITH WEATHER-TIGHT GASKETS AND FLASHING SHALL BE PROVIDED.

KITCHEN VENTILATION SYSTEM FIRE SUPPRESSION SCHEMATIC NOTES:

- REFER TO SPECIFICATIONS ON DRAWING M1 FOR SEQUENCE OF OPERATIONS.
- DETAILED DESIGN BY SUPPLIER/CONTRACTOR. SUBMIT SHOP DRAWINGS FOR REVIEW BY ENGINEER PER SPECIFICATION DRAWING M1.
- SCHEMATIC IS GENERAL ONLY. REFER TO MANUFACTURER'S INSTALLATION MANUAL FOR DETAILED WIRING INFORMATION.
- PROVIDE FACTORY PRE-PIPED NOZZLES FOR WET CHEMICAL FIRE SUPPRESSION SYSTEM CONFORMING TO NFPA 96, NFPA 17A, ULC 1254 AND AHJ REQUIREMENTS. BALLOON TEST REQUIRED, FIRE DEPARTMENT SHALL BE PRESENT TO WITNESS TEST.

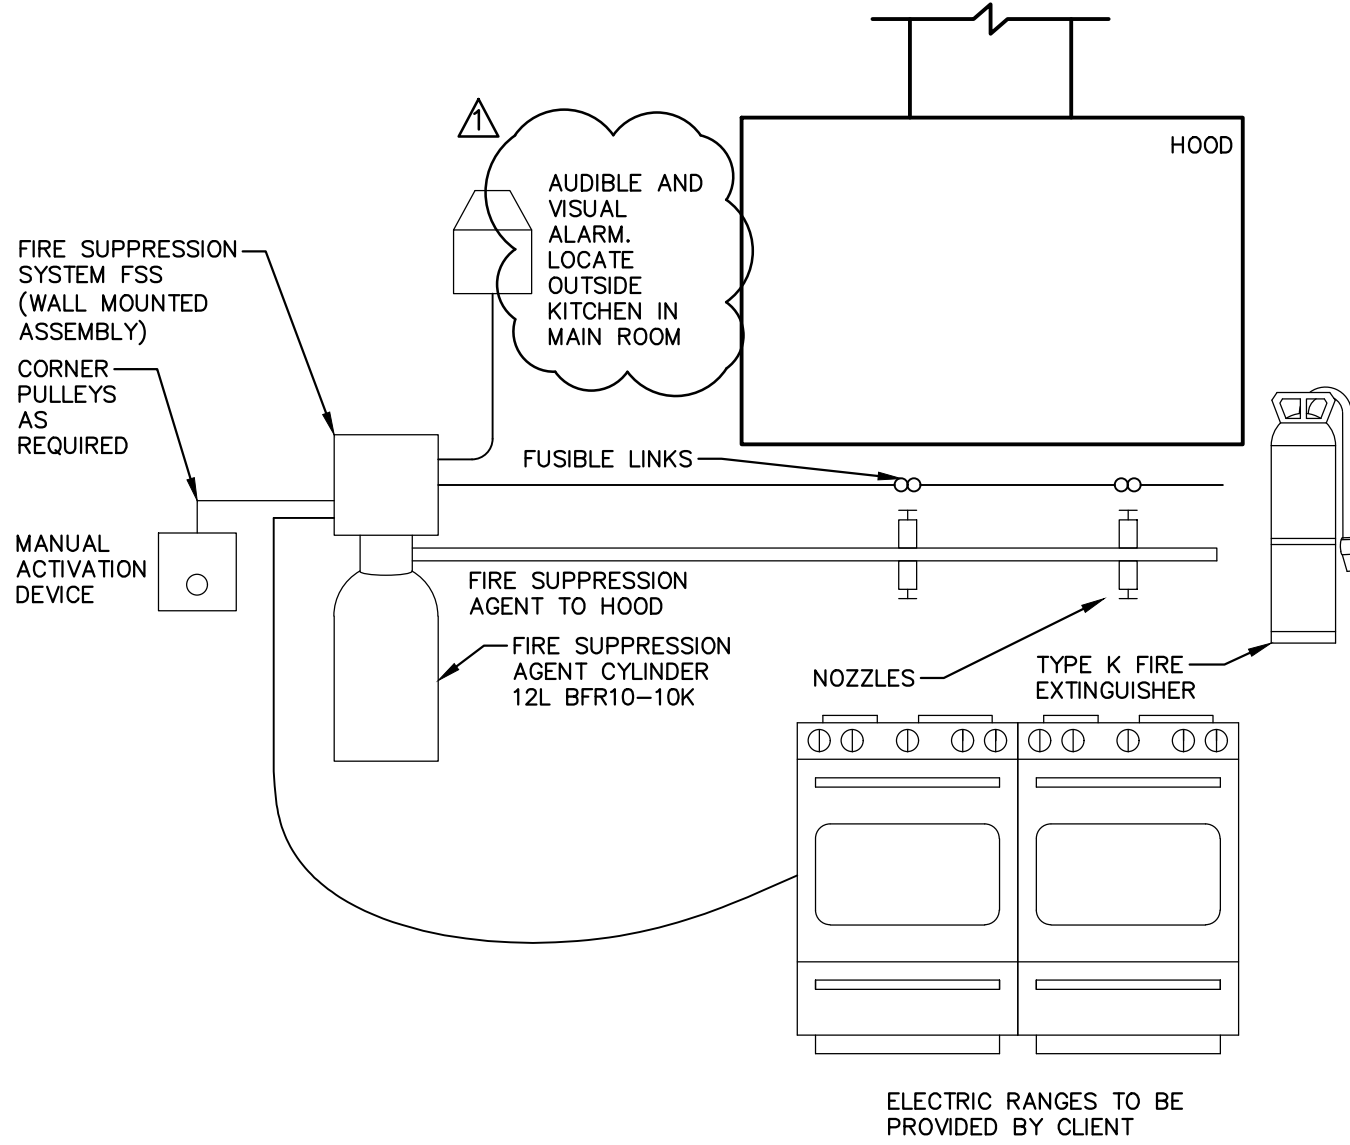

KITCHEN VENTILATION FIRE SUPPRESSION SCHEMATIC
1 M.1
SCALE: NTS

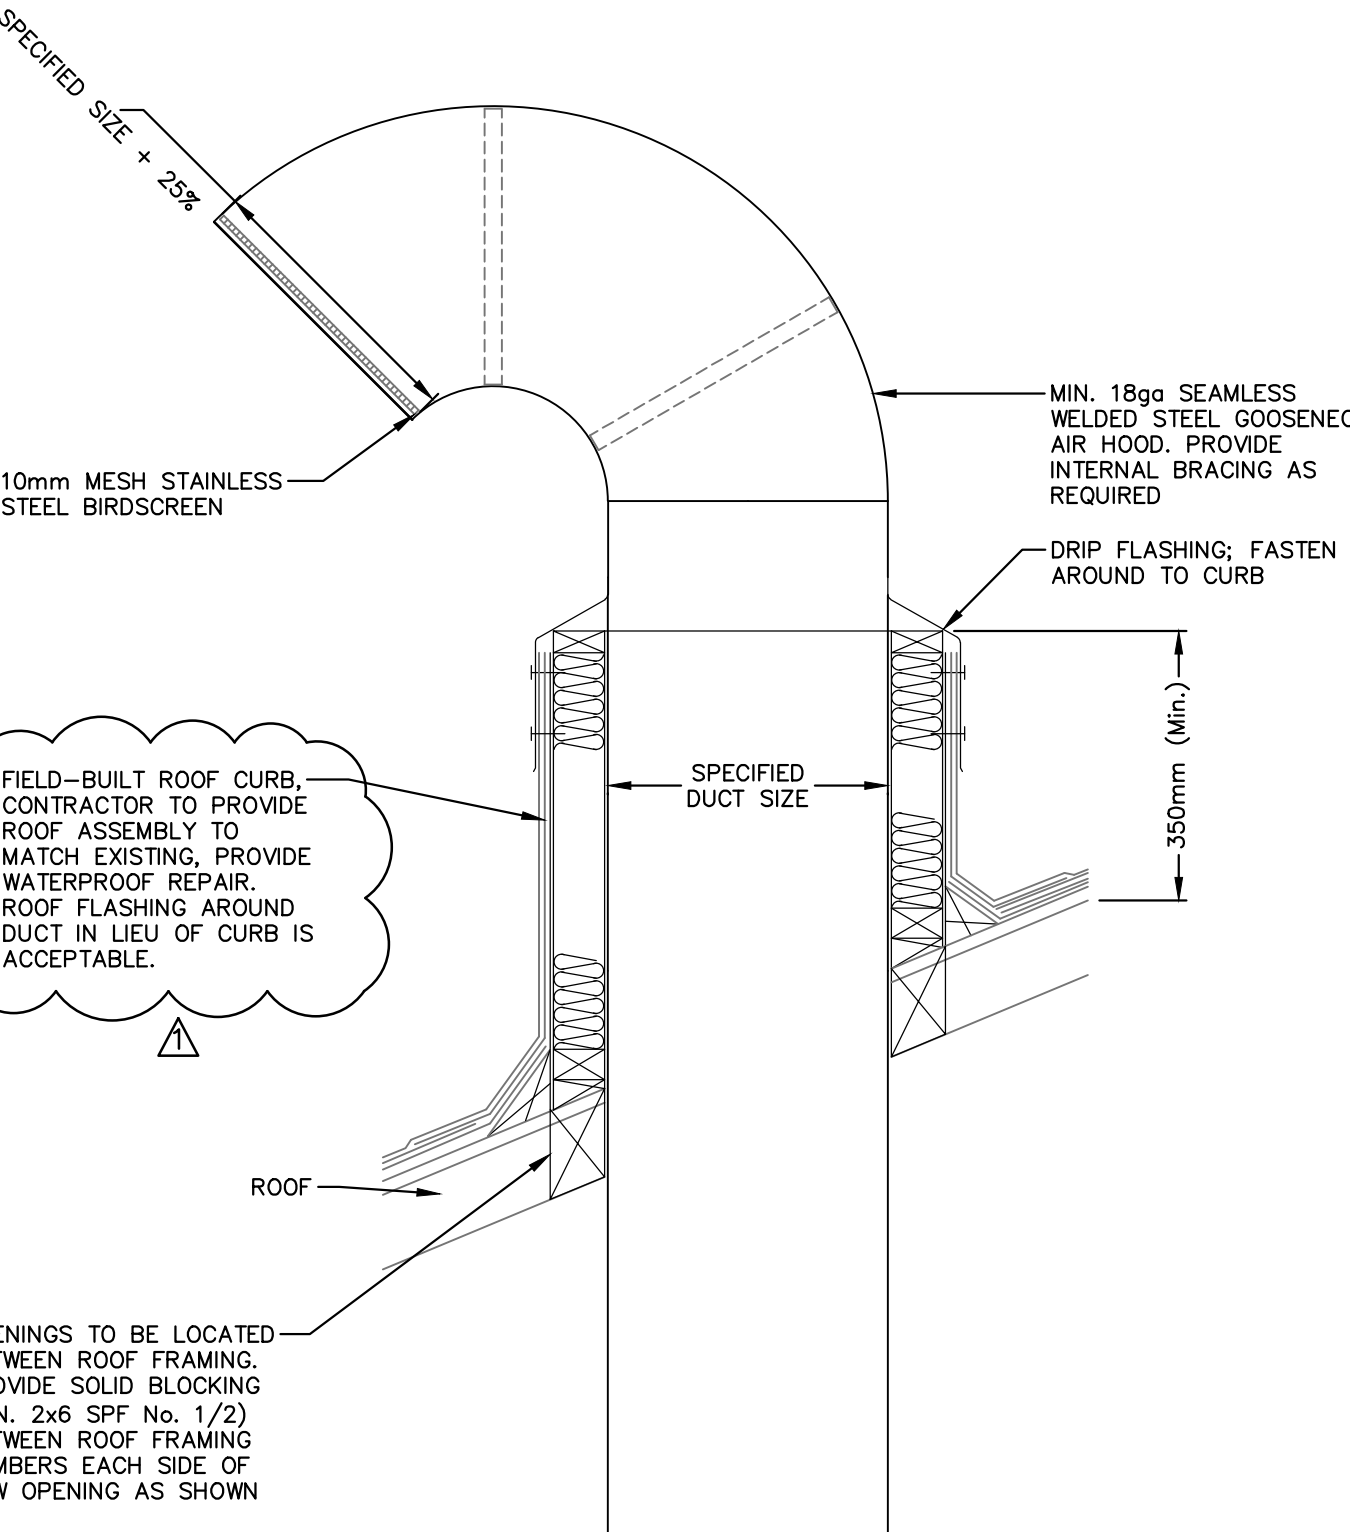

GOOSENECK EXHAUST SCHEMATIC
2 M.1
SCALE: NTS

<div>DISCLAIMER AND COPYRIGHT</div> <div>CONTRACTOR MUST VERIFY ALL DIMENSIONS AND BE RESPONSIBLE FOR SAME. ANY DISCREPANCIES MUST BE REPORTED TO THE ENGINEER BEFORE COMMENCING WORK. DRAWINGS ARE NOT TO BE SCALED.</div> <div>TATHAM ENGINEERING LIMITED CLAIMS COPYRIGHT TO THIS DRAWING WHICH MAY NOT BE USED FOR ANY PURPOSE OTHER THAN THAT PROVIDED IN THE CONTRACT BETWEEN THE OWNER/CLIENT AND THE ENGINEER WITHOUT THE EXPRESS CONSENT OF TATHAM ENGINEERING LIMITED.</div>	BENCHMARKS	NOTES	No.	REVISION DESCRIPTION	DATE	ENGINEER STAMP	<div><div>LICENSED PROFESSIONAL ENGINEER</div><div>J.C. THOMPSON</div><div>100215043</div><div>SEPT 02, 2025</div><div>PROVINCE OF ONTARIO</div></div>	WINDERMERE COMMUNITY CENTRE			<div><div>TATHAM</div><div>ENGINEERING</div></div>				
			TOWNSHIP OF MUSKOKA LAKES												
			<div>MECHANICAL</div> <div>SCHEDULES, LEGEND, SPECIFICATIONS, AND DETAILS</div>							DESIGN: AB/MCG/JT		FILE: 225023	DWG: M.1		
										DRAWN: AB/MCG		DATE: MAY 2025			
										CHECK: JT		SCALE: AS SHOWN			

