



Box 129, Port Carling, ON, POB 1JO
Telephone (705) 765-3156
Fax (705) 765-6755

THE CORPORATION OF THE TOWNSHIP OF MUSKOKA LAKES
COMMITTEE OF ADJUSTMENT

NOTICE OF PUBLIC HEARING OF APPLICATION FOR MINOR VARIANCE

This notice has been sent to you for your information and does not require any response unless you wish to make one.

TAKE NOTICE THAT the Committee of Adjustment for The Corporation of the Township of Muskoka Lakes will be considering the following proposed minor variance to Zoning By-Law 2014-14 pursuant to Section 45 of the Planning Act, R.S.O. 1990, c. P.13.

Hearing Date: Monday, January 15th, 2024 at 9:00 a.m.

File #.: A-71/23

Roll #: 4-10-040

Civic Address: 1314 Hemlock Point Road

Owner: Ann Wyganowski, 1314 Hemlock Point Road, Port Carling, ON, P0B 1J0

Legal Description: Lot 18, Concession 5, Lot 7, Plan 31, (Medora)

Lake/River: Lake Joseph (Category 1 Lake)

Zoning: Waterfront Residential (WR4)

Zoning Schedule: 28

EXPLANATION OF THE PURPOSE AND EFFECT: The applicant proposes to recognize an as-built boatlift and jet ski lift.

Variance	ZBL 2014-14 Section(s)	Description	Permitted	Proposed	Variance
A	4.1.7 & 4.1.7.1	Minimum Side Yard Setback for a Boatlift from the Westerly Side Lot Line Projection	30 ft.	27 ft.	3 ft.
B	4.1.7 & 4.1.7.12 a.	Maximum Cumulative Dock Width (Including Boatlift)	35.6 ft. (25%)	40.9 ft. (28.6%)	5.3 ft.

A key map of the subject property and the applicant’s site plan and any drawings are included in this notice.

TAKE FURTHER NOTICE that this public hearing will be held in a hybrid forum with electronic ZOOM participation, and in-person format for those wish to attend in person. The meeting will be held in the **Council Chambers, Municipal Office, 1 Bailey Street, Port Carling, Ontario, and will commence at**

9:00 a.m. More information about viewing and/or participating in the ZOOM hearing is included in this Notice and can be found on our website at www.muskokalakes.ca.

ADDITIONAL INFORMATION relating to the proposed variance application is available from the Planning Department week days between 8:15 a.m. and 4 p.m. at the Municipal Office, or at planning@muskokalakes.ca or by phone at (705)765-3156, by Fax at (705) 765-6755, or by mail at The Corporation of the Township of Muskoka Lakes, Box 129, Port Carling, Ontario, P0B 1J0.

Please quote the file number noted above.

YOU OR YOUR REPRESENTATIVE are entitled to participate in this public hearing and make verbal representation and/or make written representation prior to the meeting. Comments can be submitted by emailing planning@muskokalakes.ca or by regular mail or the Municipal Office drop box outside the main entrance to the Municipal Office located at 1 Bailey St., Port Carling.

IF YOU WISH TO SPEAK to the Committee of Adjustment at the hearing by electronic participation, please contact planning@muskokalakes.ca by 9:00 a.m. on the regular business day preceding the scheduled hearing.

FAILURE TO PARTICIPATE IN HEARING: If you do not participate in the hearing it may proceed in your absence and, except as otherwise provided in the Planning Act, you will not be entitled to any further notice in the proceedings.

NOTICE OF DECISION: If you wish to be notified of the decision of the Committee of Adjustment in respect of this application, you must submit a written request to the Committee of Adjustment.

NO ONE OTHER THAN the applicant, the municipality, certain public bodies and the minister may file an appeal of the decision of the Committee of Adjustment in respect of the proposed variance. If they do not make written submission to the Secretary Treasurer before the variance is approved or refused, then the Ontario Land Tribunal may dismiss the appeal.

THE HEARING will be live-streamed on the Township's live webcast at: www.muskokalakes.ca If the live webcast fails, the meeting recording will be posted at: <https://muskokalakes.civicweb.net/Portal/>

PLEASE NOTE: THE COMMITTEE OF ADJUSTMENT IS A JUDICIAL BODY WHICH MAKES DECISIONS SOLELY ON INFORMATION GATHERED AS A COMMITTEE. COMMITTEE MEMBERS ARE NOT TO BE CONTACTED PRIOR TO THE HEARING DATE TO AVOID A CONFLICT OF INTEREST.

Dated this 3rd day of January, 2024.

"Original Signed by C. Ward"
Chelsea Ward,
Secretary-Treasurer
Committee of Adjustment

KEY MAP




SITE PLAN

NOT TO SCALE

PART OF LOT 19, CONCESSION 5
 GEOGRAPHIC TOWNSHIP OF MEDORA
 TOWNSHIP OF MUSKOKA LAKES
 DISTRICT MUNICIPALITY OF MUSKOKA

SCALE 1" = 30'

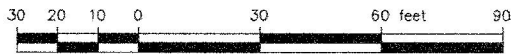


ANN WYGANOWSKI PROPERTY
 1314 HEMLOCK POINT ROAD
 LOT 7 OF REGISTERED PLAN 31
 Roll# 4453-040-010-04000
 PIN 48147-0176 (LT)
 Zoning WR4

AREA ANALYSIS

TOTAL SITE AREA:	27100 S.F.	0.62 Ac.
LOT AREA WITHIN 200' OF SHORE:	26870 S.F.	0.62 Ac.
COTTAGE COVERAGE AREA: (incl. covered porch)	1666 S.F.	
SHED COVERAGE AREAS:	100 S.F.	
WOOD SHED COVERAGE AREA:	35 S.F.	
NEW GARAGE COVERAGE AREA:	53 S.F.	
TOTAL LOT COVERAGE:	2190 S.F.	
PERCENT COVERAGE WITHIN 200' OF SHORE:	8.2%	

PILE
NOT A SHED
53 SF
89% 2137 SF

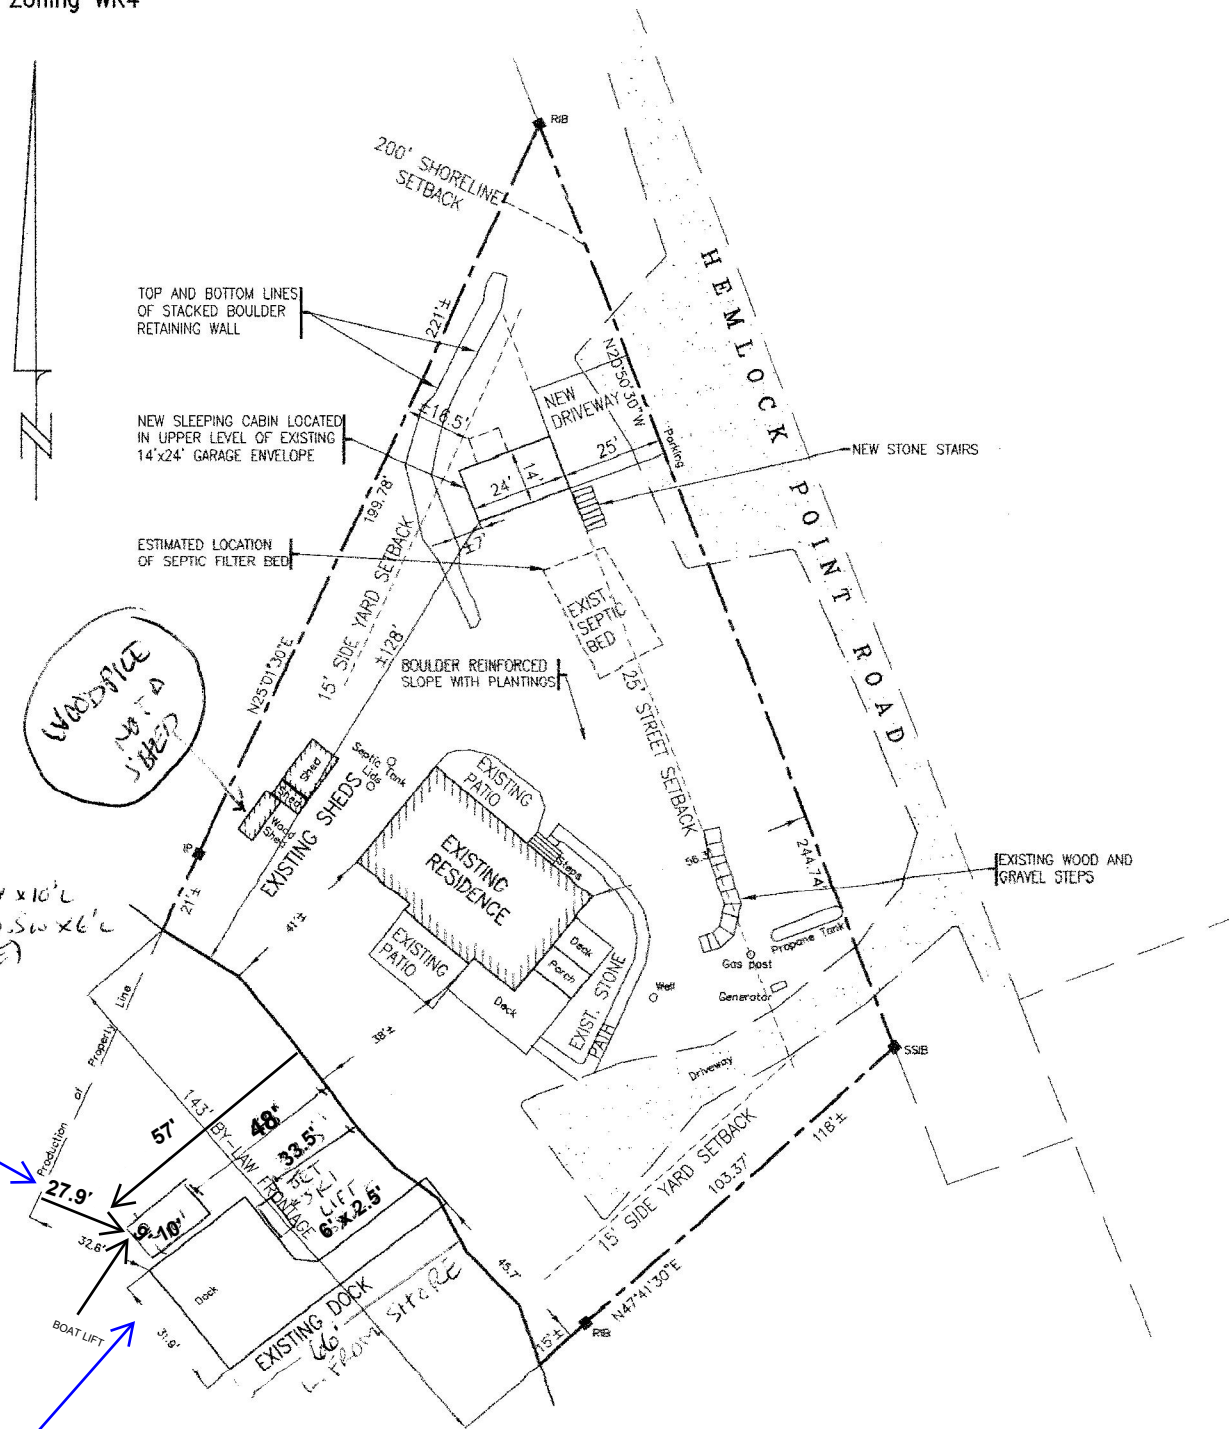

LAKE JOSEPH