



1 Bailey Street
Port Carling, ON P0B 1J0

E: planning@muskokalakes.ca P: 705-765-3156 F: 705-765-6755

COMMITTEE OF ADJUSTMENT - NOTICE OF HEARING


THE CORPORATION OF THE TOWNSHIP OF MUSKOKA LAKES

To consider an application for a proposed minor variance to Zoning By-law 2014-14 pursuant to Section 45 of the Planning Act, R.S.O., 1990, Chapter P. 13, as amended. **This notice has been sent to you for information and does not require any response unless you wish to make one.**

File No.: A-30/24
Roll No.: 4-23-040

Owners:	Richard, Nancy and Samantha Claydon, Emily Reed and Stefanie Koornneef, 227 Howland Ave, Toronto, ON, M5R 3B7		
Address & Description:	1919 Mortimers Point Road, Unit #1 Part of Lot 28, Concession C, Part 4, Plan 35R-13119 (Medora)		
Zoning:	Waterfront Residential (WR5)	Lake Muskoka (Category 1 Lake)	Schedule: 42
Hearing Date: Monday, May 13th, 2024 at 9:00 a.m.			

Take further notice that this public hearing will be held in a hybrid forum with electronic Zoom participation, and in-person format for those wishing to attend in-person. The hearing will be held in the **Council Chambers, Municipal Office, 1 Bailey Street, Port Carling, ON**. Should you wish to view an electronic copy of the Notice of Hearing for the above-noted application, please visit <https://www.muskokalakes.ca/planning-notices/> or scan the QR code.

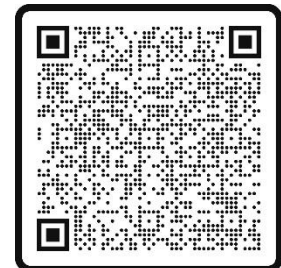

Explanation of the Purpose and Effect:


The applicant proposes to recognize as-built stairs and landings within the required interior side yard setback.

Variance	ZBL 2014-14 Section(s)	Description	Permitted	Proposed	Variance
A	Table 4.1.3	Minimum Interior Side Yard Setback	15 ft.	4.5 ft.	10.5 ft.

A key map of the subject property and the applicants' site plan and any drawings are included in this notice.



KEY MAP

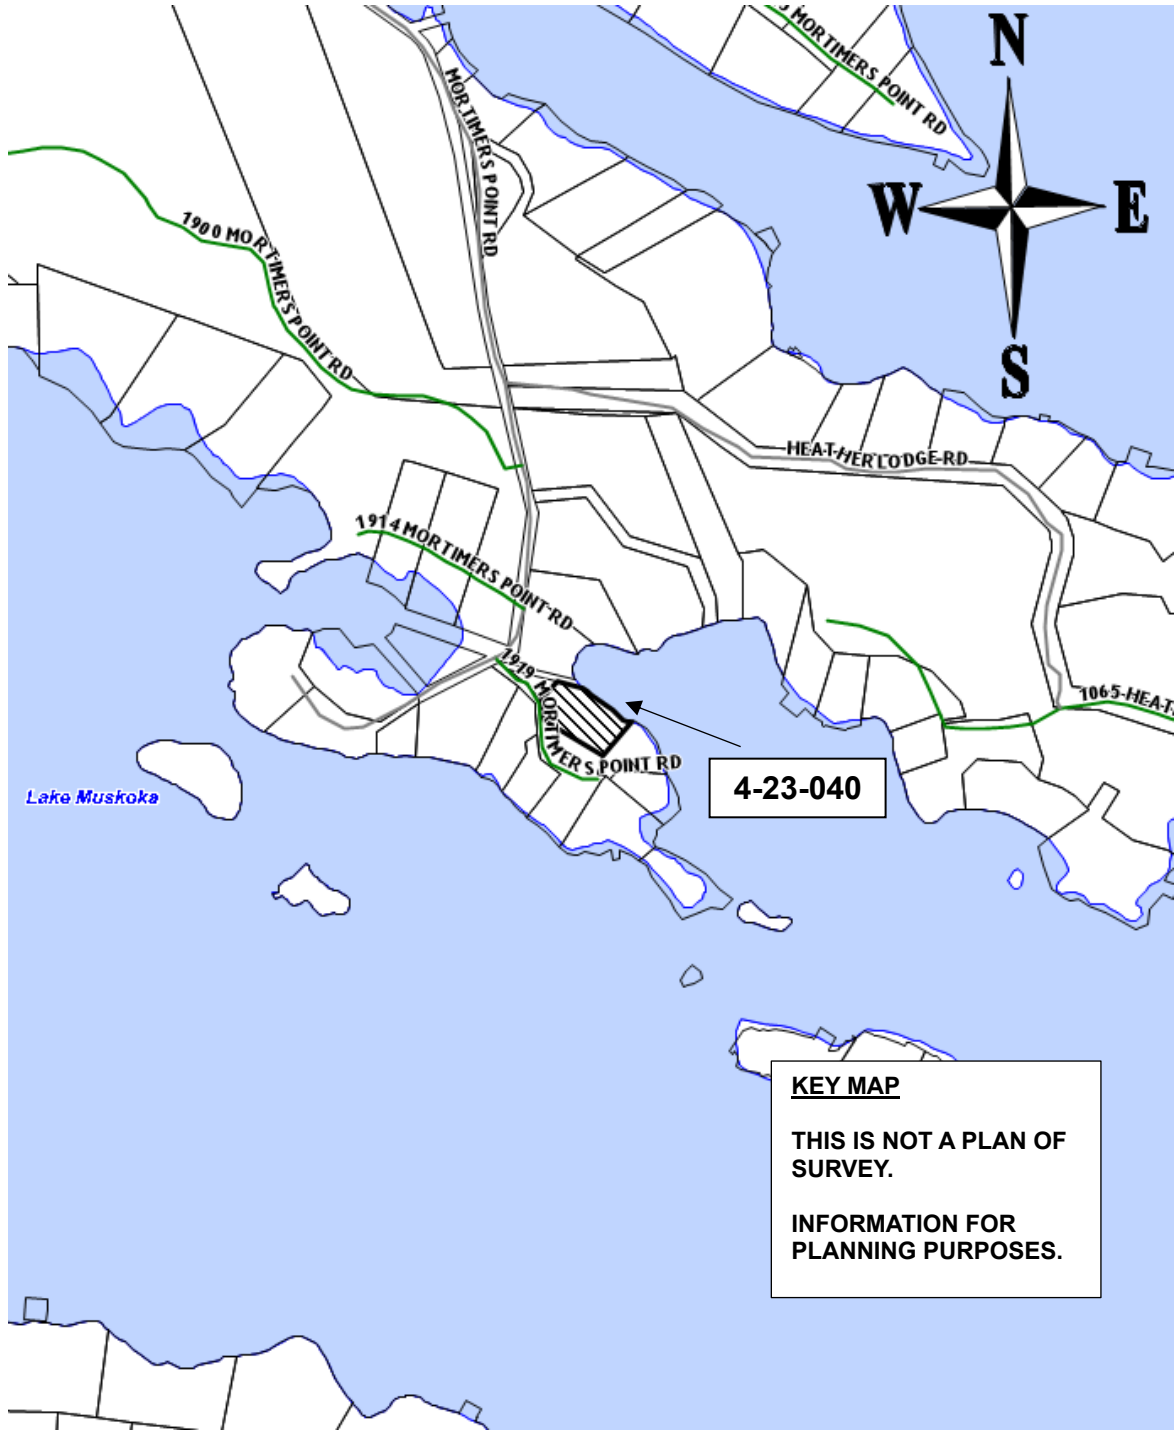

For more information, please contact the Planning Division weekdays between 8:15 a.m. and 4 p.m. at the Municipal Office, or at planning@muskokalakes.ca or by phone at (705) 765-3156. **Please quote the file number noted above.**



How to Participate:

Submit Comments in Writing



Submit comments to planning@muskokalakes.ca, deliver in-person, or mail to P.O. Box 129, 1 Bailey Street, Port Carling, ON, P0B 1J0

Personal information collected in response to this Notice of Hearing will be used to assist staff and Council to process this application and will be made public.

Active Participation In-Person or on Zoom



Hybrid hearings are held at 9:00 a.m. on the above-noted hearing date in Council Chambers at the Municipal Office. For more information about participating via Zoom, visit www.muskokalakes.ca/zoom

If you wish to speak to the Committee of Adjustment at the hearing by electronic participation, please contact planning@muskokalakes.ca by 9:00 a.m. on the regular business day preceding the scheduled hearing.

Watch the Hearing Online



You can access the hearing from YouTube on the Township of Muskoka Lakes YouTube Channel. If the live webcast fails, the hearing recording will be posted under the Government Portal on www.muskokalakes.ca

FAILURE TO PARTICIPATE IN HEARING: If you do not participate in the hearing it may proceed in your absence and, except as otherwise provided in the Planning Act, you will not be entitled to any further notice in the proceedings.

DECISION & APPEALS: If you wish to be notified of the decision of the Committee of Adjustment in respect to this application, you must make a written request to planning@muskokalakes.ca. Furthermore, **no one other than** the applicant, the municipality, certain public bodies and the minister may file an appeal of the decision of the Committee of Adjustment in respect of the proposed variance. If they do not make a written submission to the Secretary Treasurer before the variance is approved or refused, then the Ontario Land Tribunal may dismiss the appeal.


PLEASE NOTE: The Committee of Adjustment is a judicial body which makes decisions solely on the information gathered as a Committee. Committee members are not to be contacted prior to the hearing date to avoid a conflict of interest.

Dated at the Township of Muskoka Lakes
this 2nd day of May, 2024.

Chelsea Ward, Secretary-Treasurer
Committee of Adjustment
planning@muskokalakes.ca



SITE PLAN

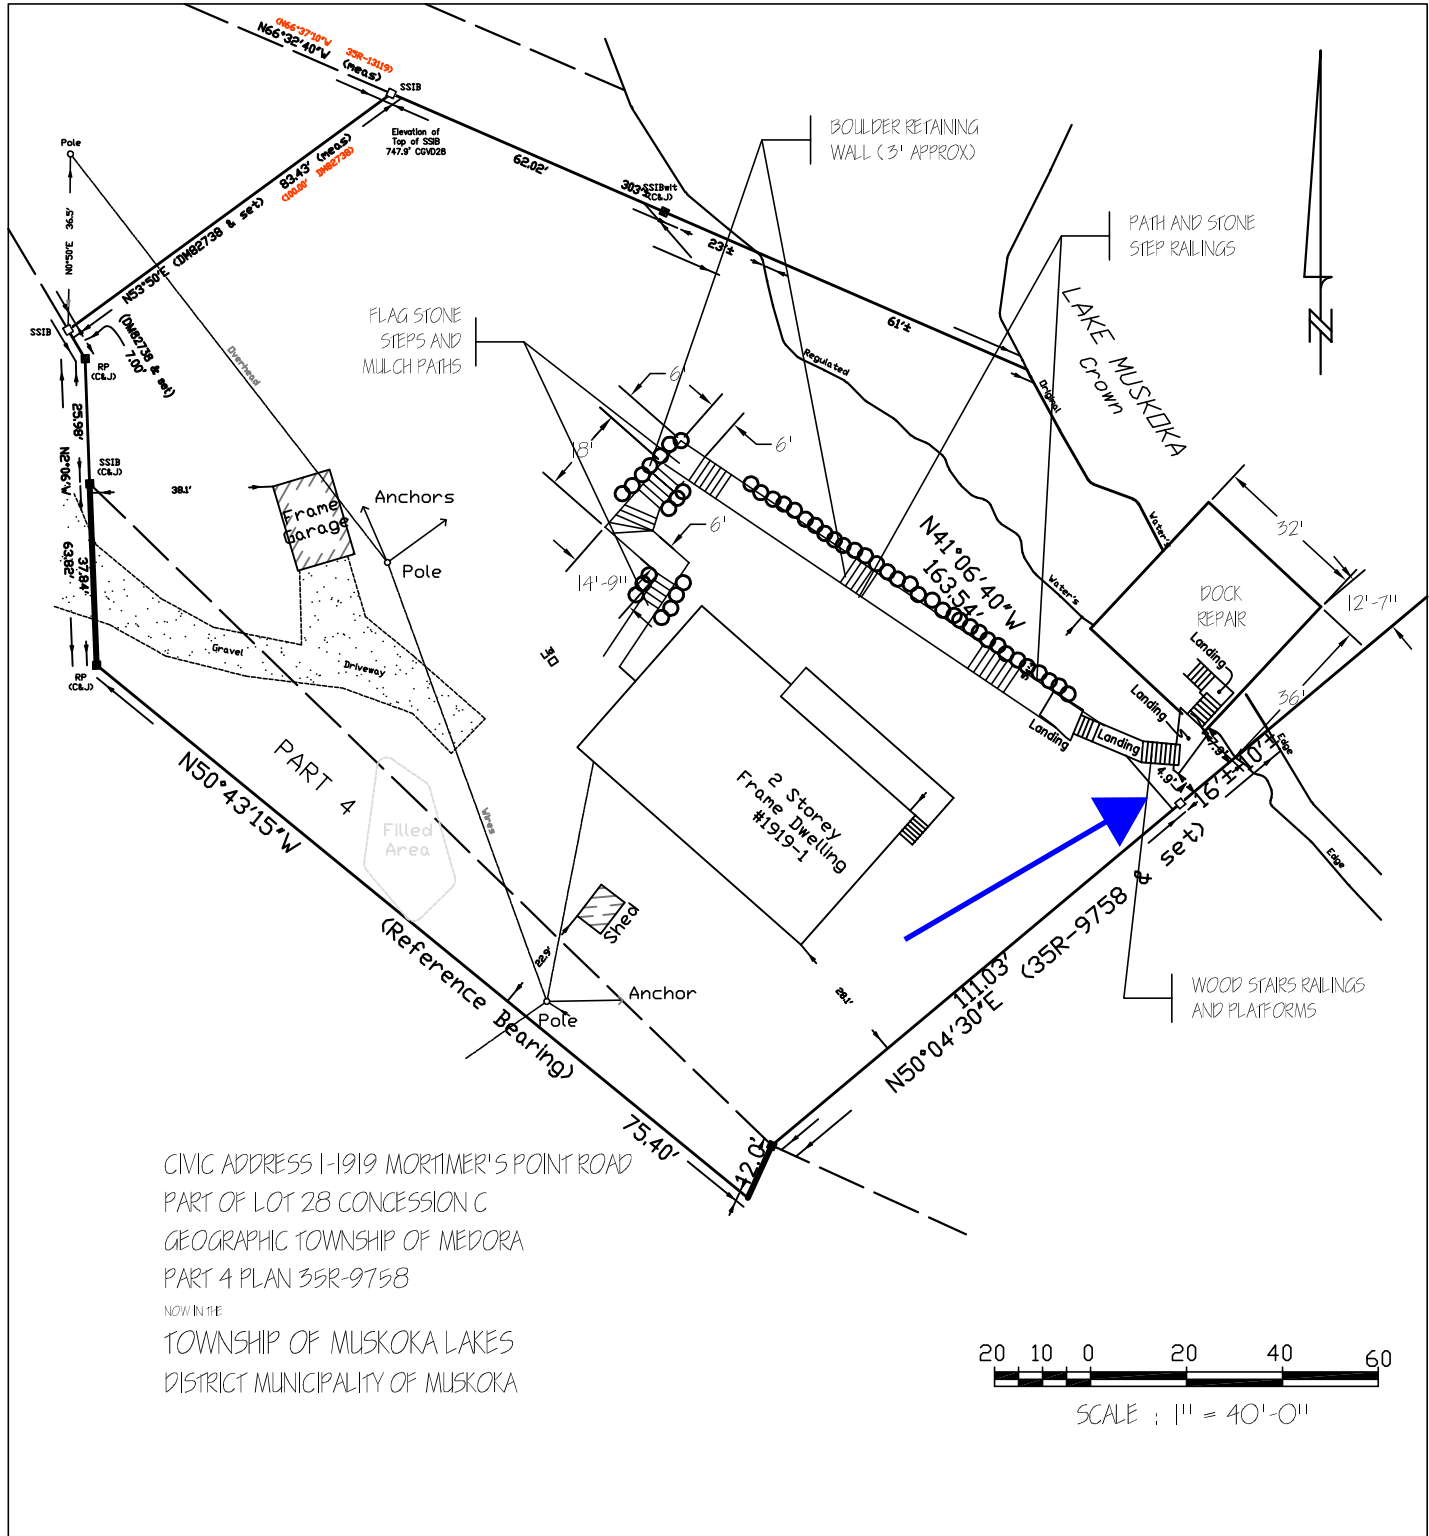

CIVIC ADDRESS 1-1919 MORTIMER'S POINT ROAD
PART OF LOT 28 CONCESSION C
GEOGRAPHIC TOWNSHIP OF MEDORA
PART 4 PLAN 35R-9758
NOW IN THE
TOWNSHIP OF MUSKOKA LAKES
DISTRICT MUNICIPALITY OF MUSKOKA

20 10 0 20 40 60
SCALE : 1'' = 40'-0''